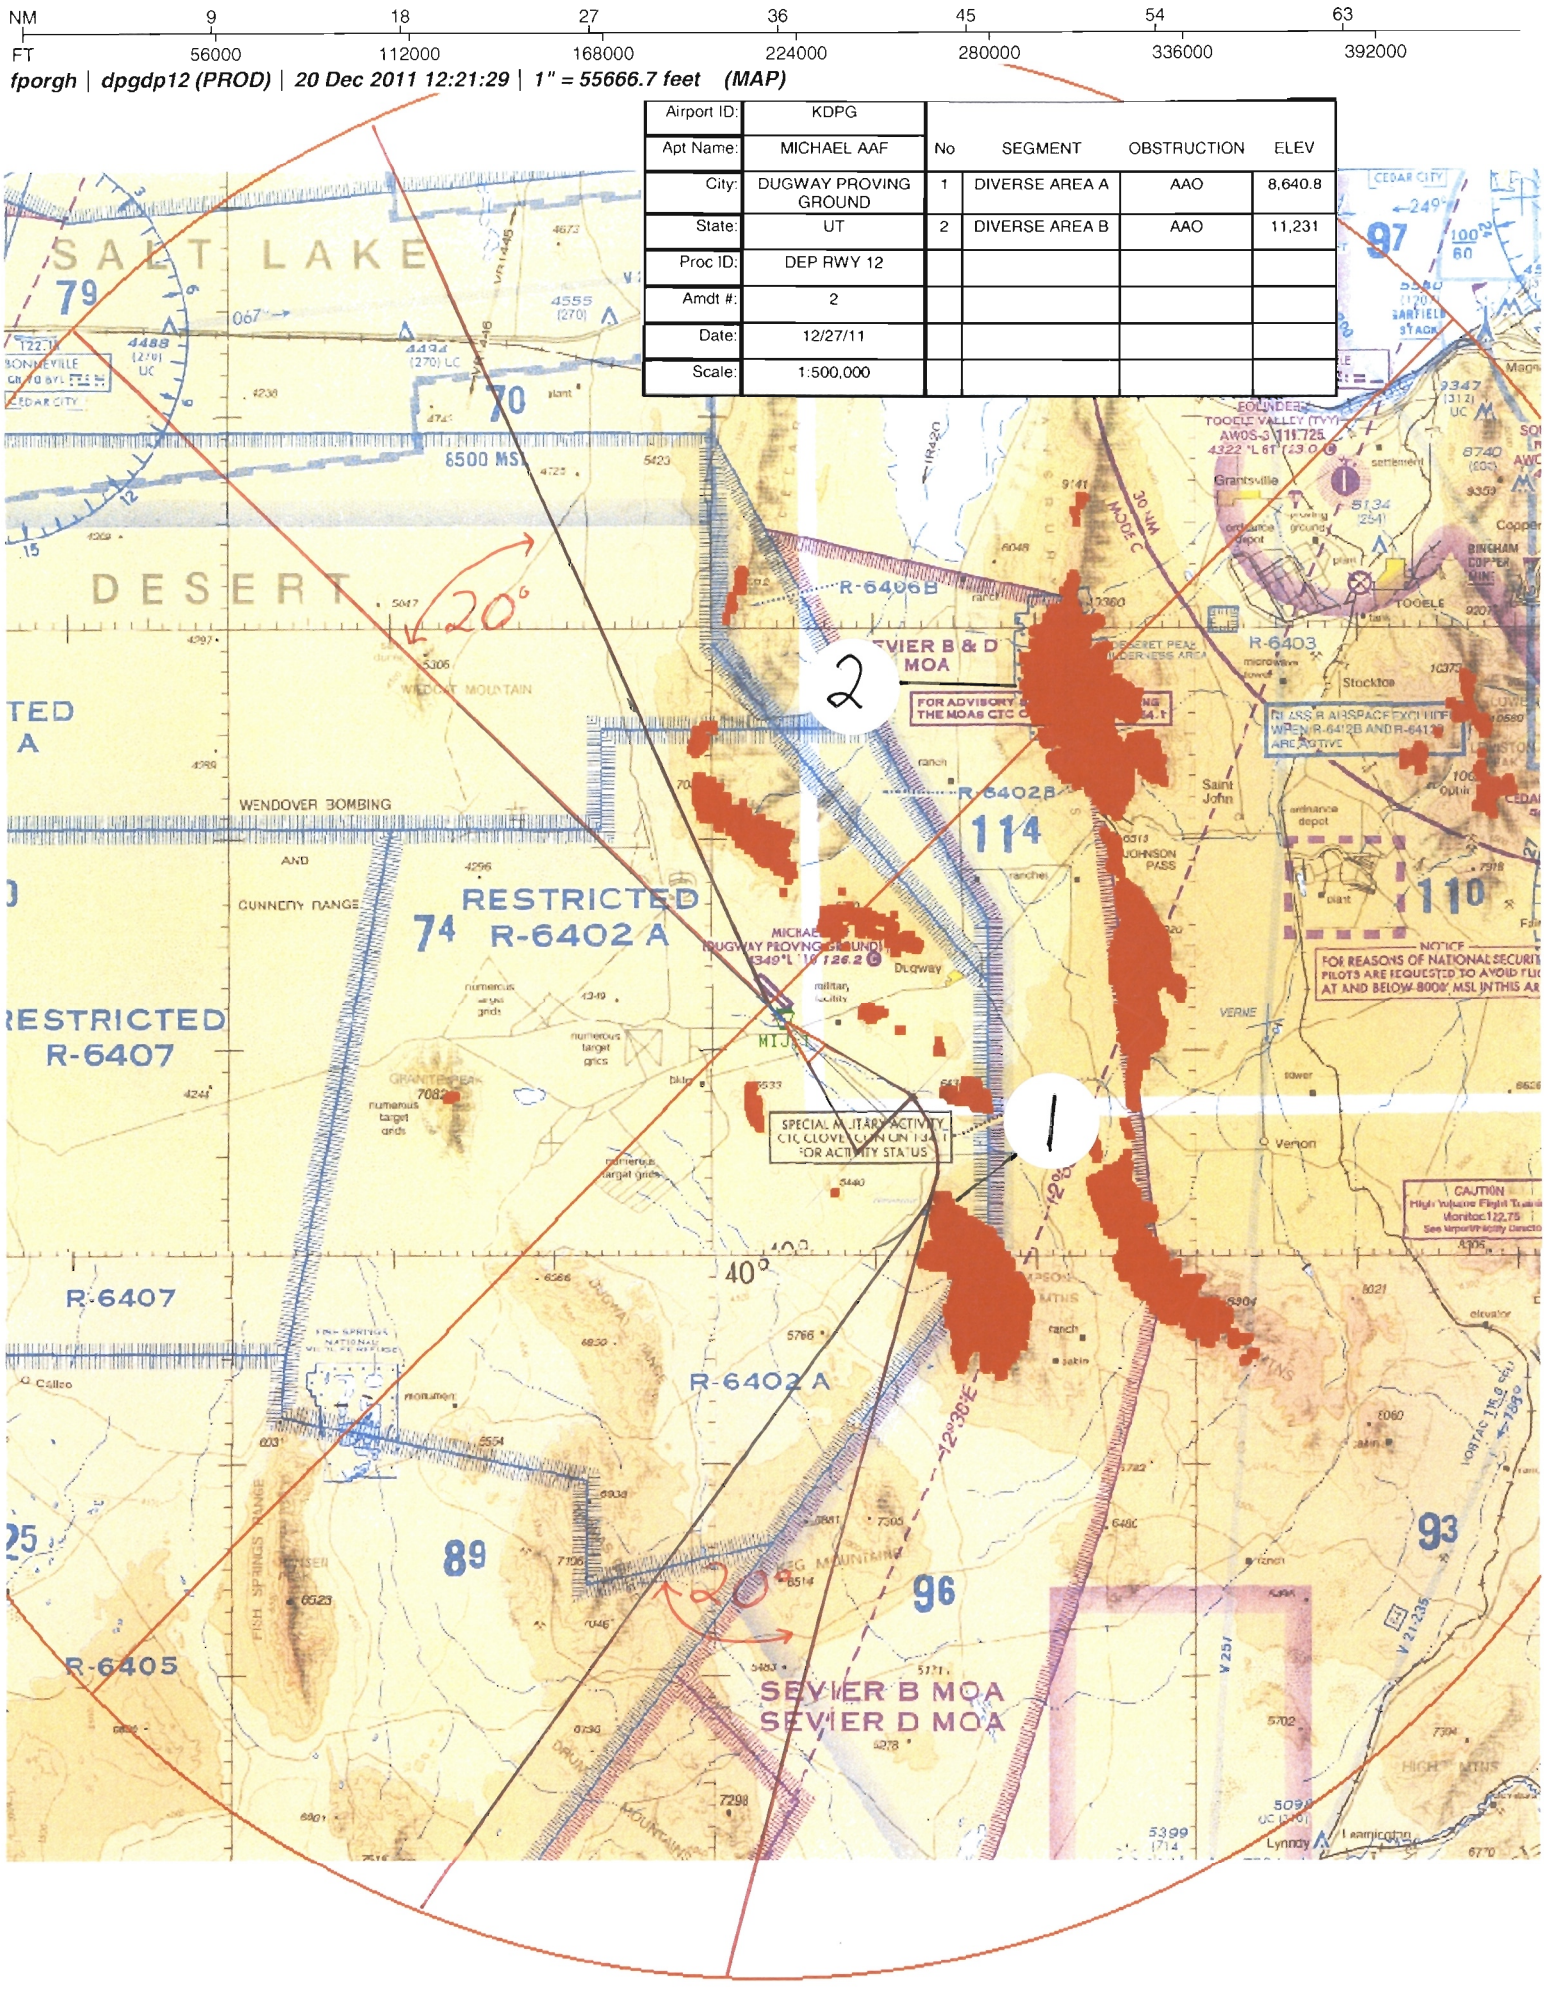
NM 9 18 27 36 45 54 63
FT 56000 112000 168000 224000 280000 336000 392000
fporgh | dpgdp12 (PROD) | 20 Dec 2011 12:21:29 | 1" = 55666.7 feet (MAP)
Airport ID: KDPG
Apt Name: MICHAEL AAF
City: DUGWAY PROVING GROUND
State: UT
Proc ID: DEP RWY 12
Amdt #: 2
Date: 12/27/11
Scale: 1:500,000
No SEGMENT OBSTRUCTION ELEV
1 DIVERSE AREA A AAO 8,640.8
2 DIVERSE AREA B AAO 11,231
SALT LAKE
DESERT
R-6406B
SEVIER B & D MOA
R-6403
R-6402B
RESTRICTED R-6402 A
WENDOVER BOMBING AND GUNNERY RANGE
RESTRICTED R-6407
R-6407
R-6402 A
R-6405
SEVIER B MOA
SEVIER D MOA
Grantsville
Stockton
Saint John
Vernon
Dugway
6500 MSL
20°
40°
120°
30 NM MODE C
FOR ADVISORY THE MOAS CTC
CLASS B AIRSPACE EXCLUDE WHEN R-6412B AND R-6413 ARE ACTIVE
NOTICE FOR REASONS OF NATIONAL SECURITY PILOTS ARE REQUESTED TO AVOID
SPECIAL MILITARY ACTIVITY CTC CLOVE COMM ON 134.1 FOR ACTIVITY STATUS
CAUTION High Volume Flight Training Monitor 122.75
1
2

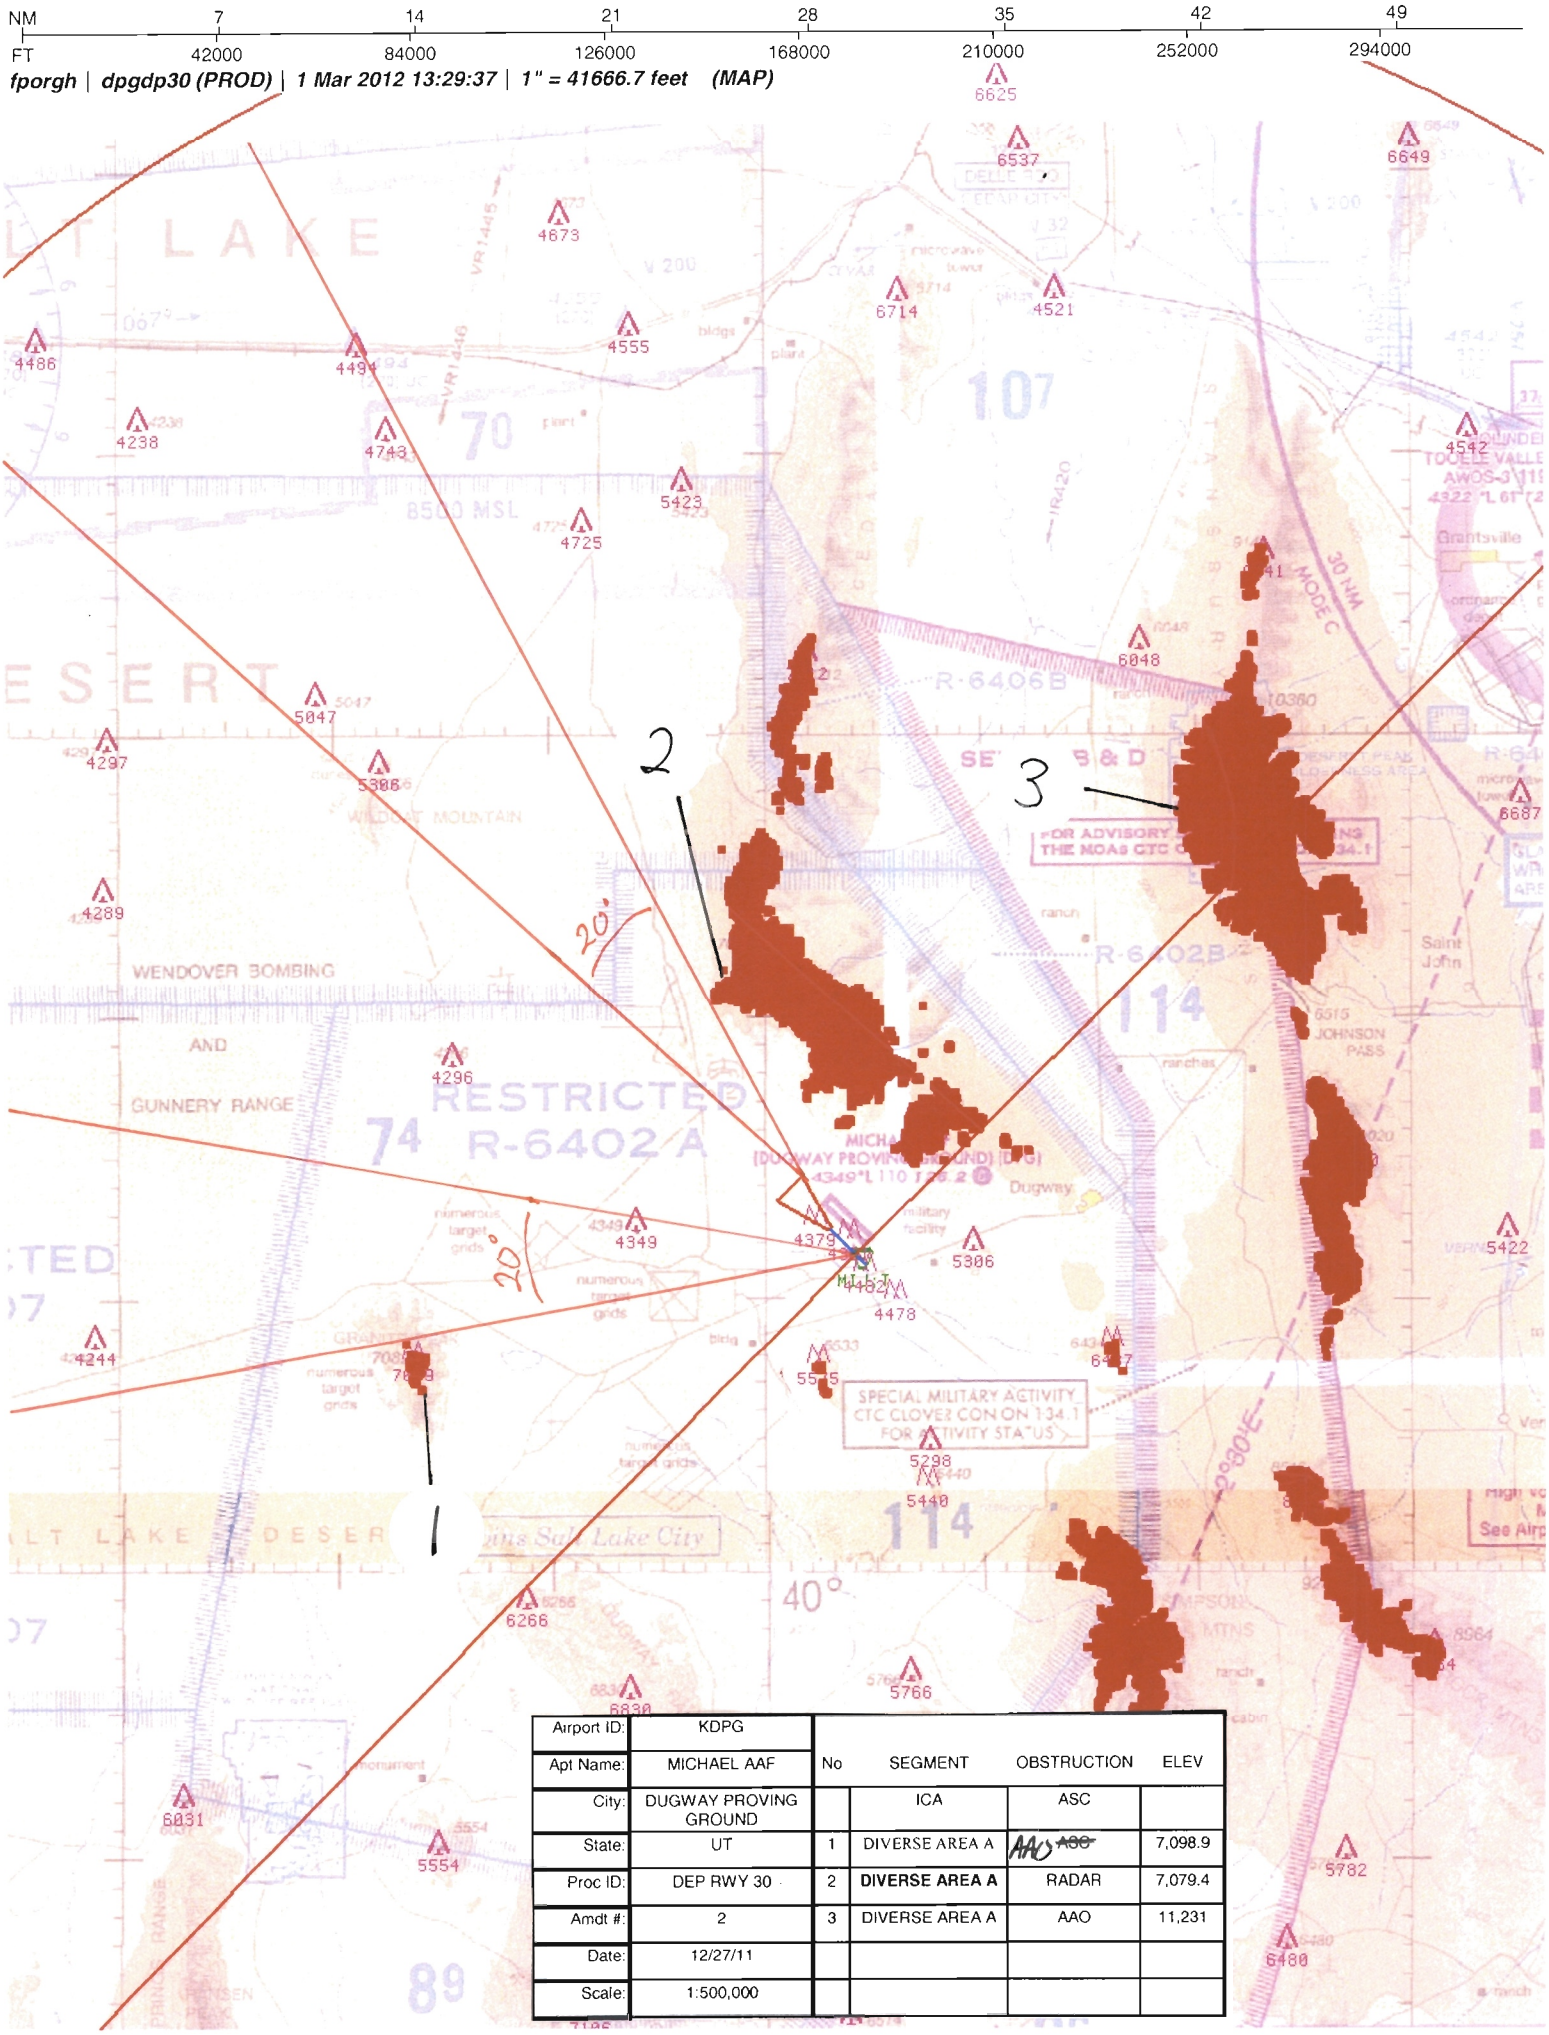

Airport ID:	KDPG
Apt Name:	MICHAEL AAF
City:	DUGWAY PROVING GROUND
State:	UT
Proc ID:	DEP RWY 30
Amdt #:	2
Date:	12/27/11
Scale:	1:500,000

No	SEGMENT	OBSTRUCTION	ELEV
	ICA	ASC	
1	DIVERSE AREA A	AAO ~~ASC~~	7,098.9
2	**DIVERSE AREA A**	RADAR	7,079.4
3	DIVERSE AREA A	AAO	11,231

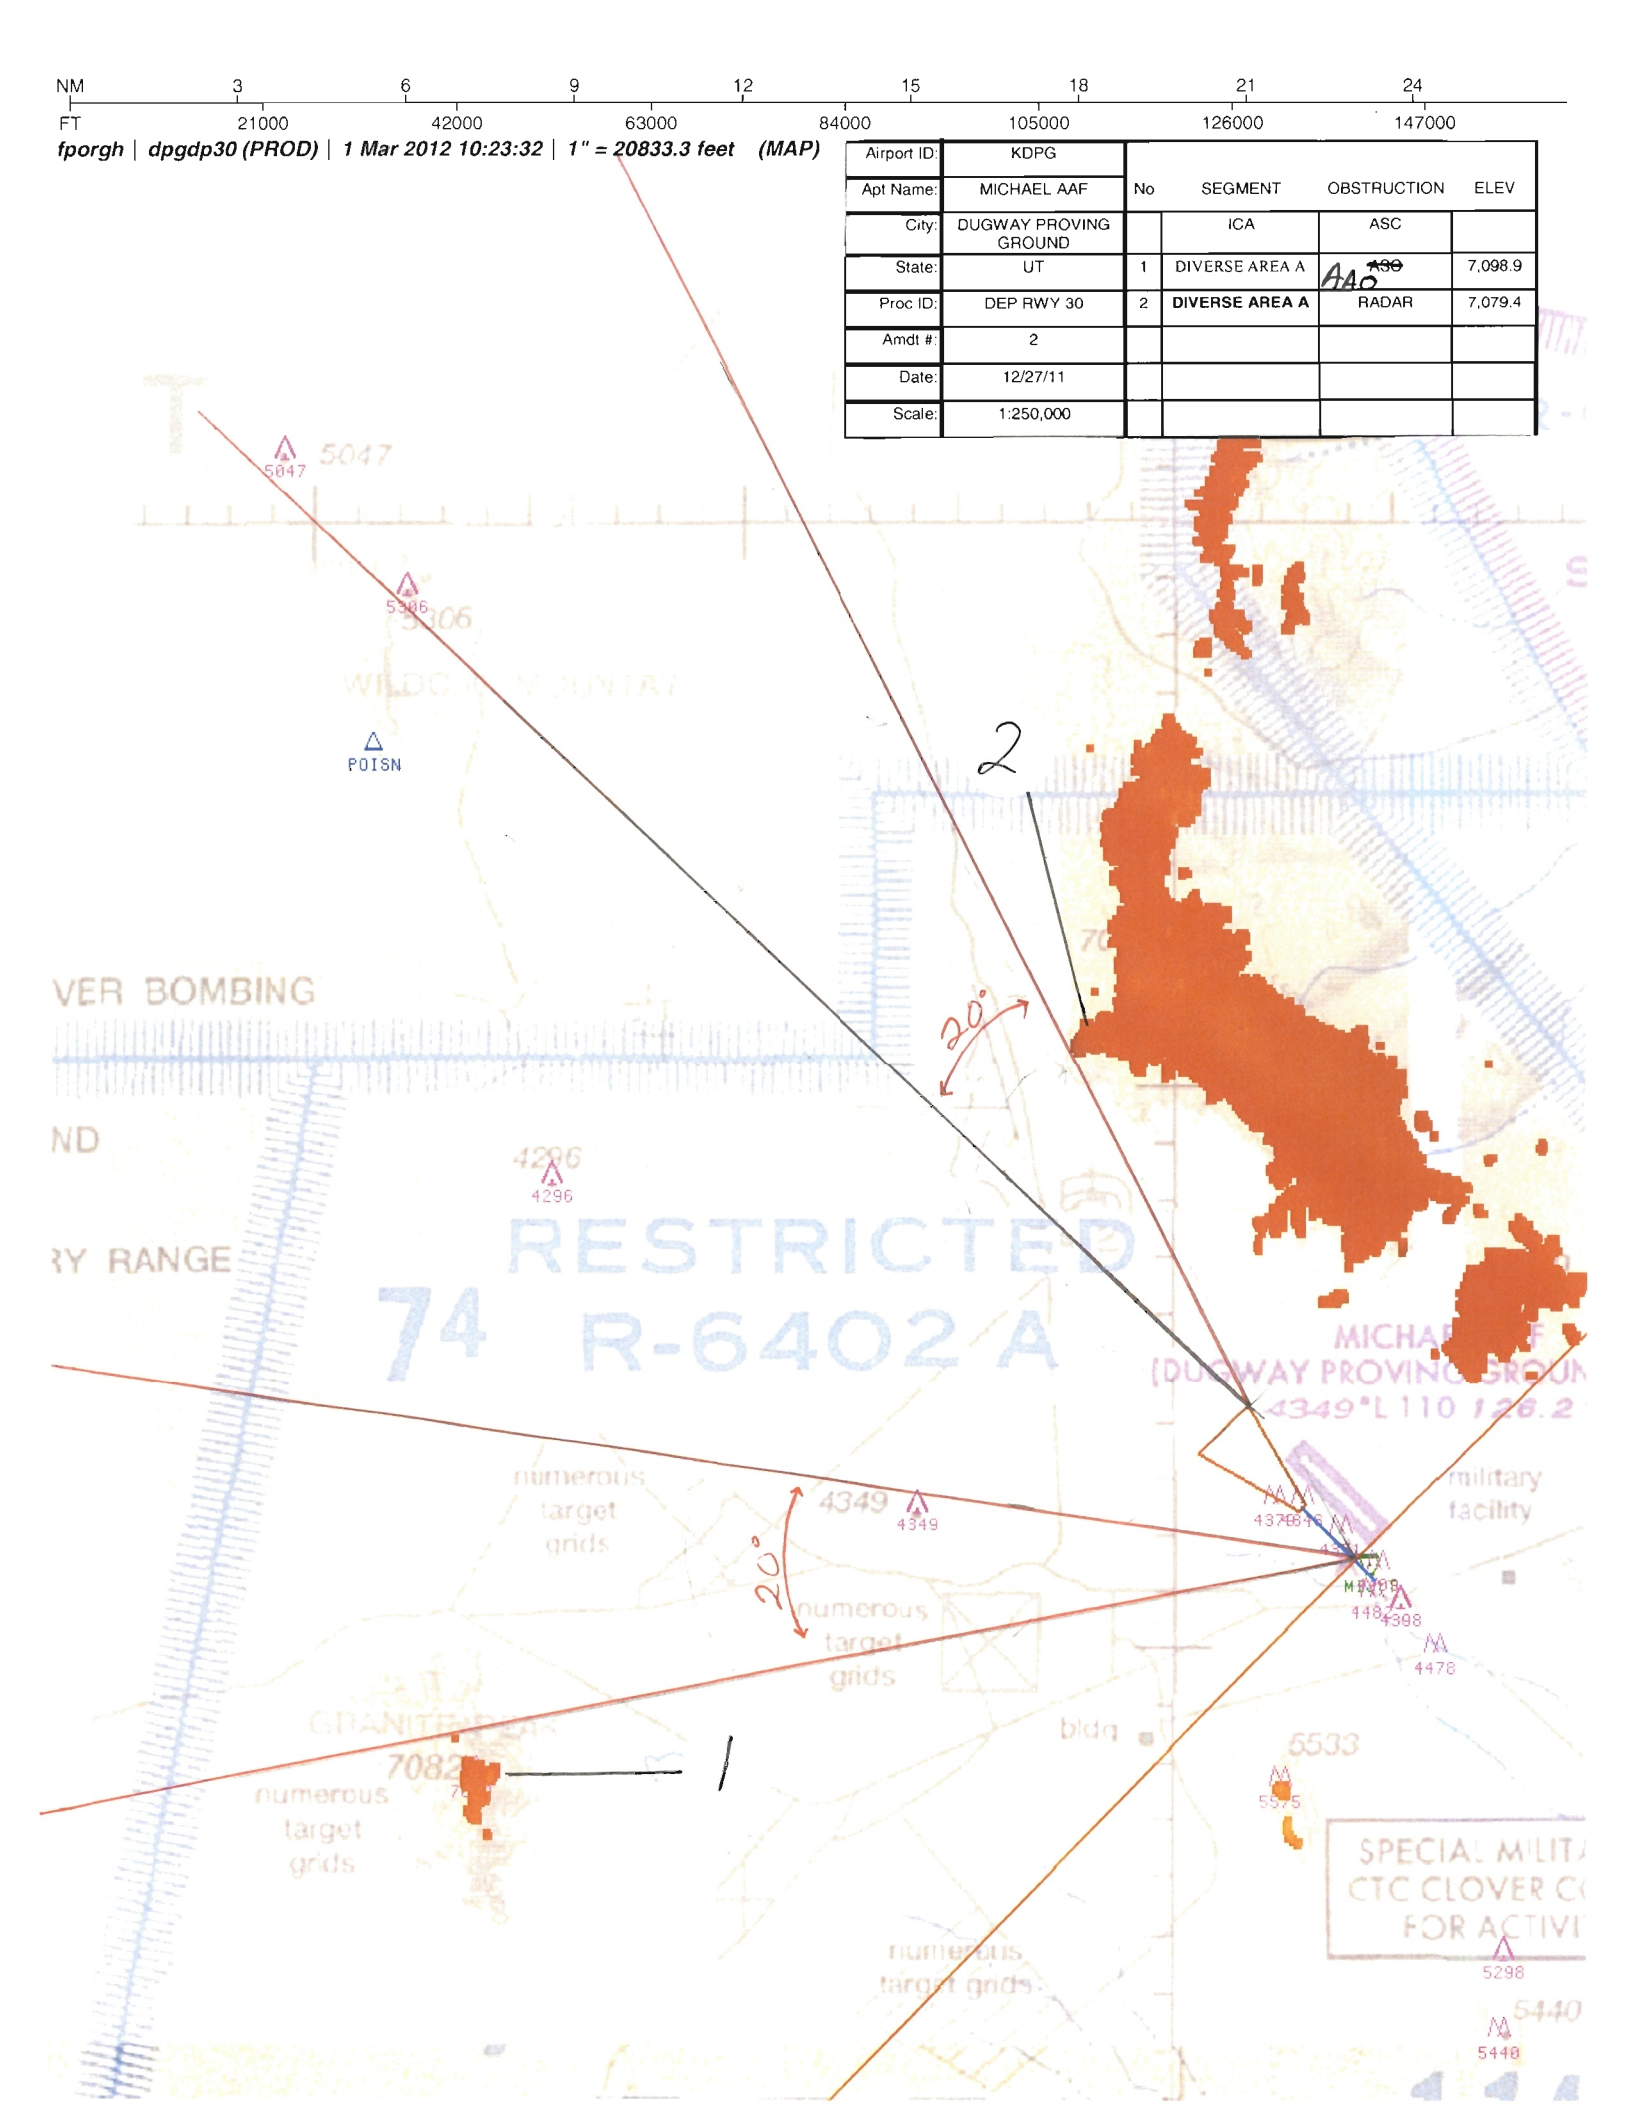
NM 3 6 9 12 15 18 21 24
FT 21000 42000 63000 84000 105000 126000 147000
fporgh | dpgdp30 (PROD) | 1 Mar 2012 10:23:32 | 1" = 20833.3 feet (MAP)
Airport ID: KDPG
Apt Name: MICHAEL AAF
City: DUGWAY PROVING GROUND
State: UT
Proc ID: DEP RWY 30
Amdt #: 2
Date: 12/27/11
Scale: 1:250,000
No SEGMENT OBSTRUCTION ELEV
ICA ASC
1 DIVERSE AREA A AAO ~~ASO~~ 7,098.9
2 DIVERSE AREA A RADAR 7,079.4
POISN
5047
5306
4296
4349
4398
4478
5533
5298
5440
20°
20°
2
1
RESTRICTED
R-6402A
VER BOMBING
RY RANGE
numerous target grids
military facility
bldg
SPECIAL MILIT
CTC CLOVER C
FOR ACTIVI

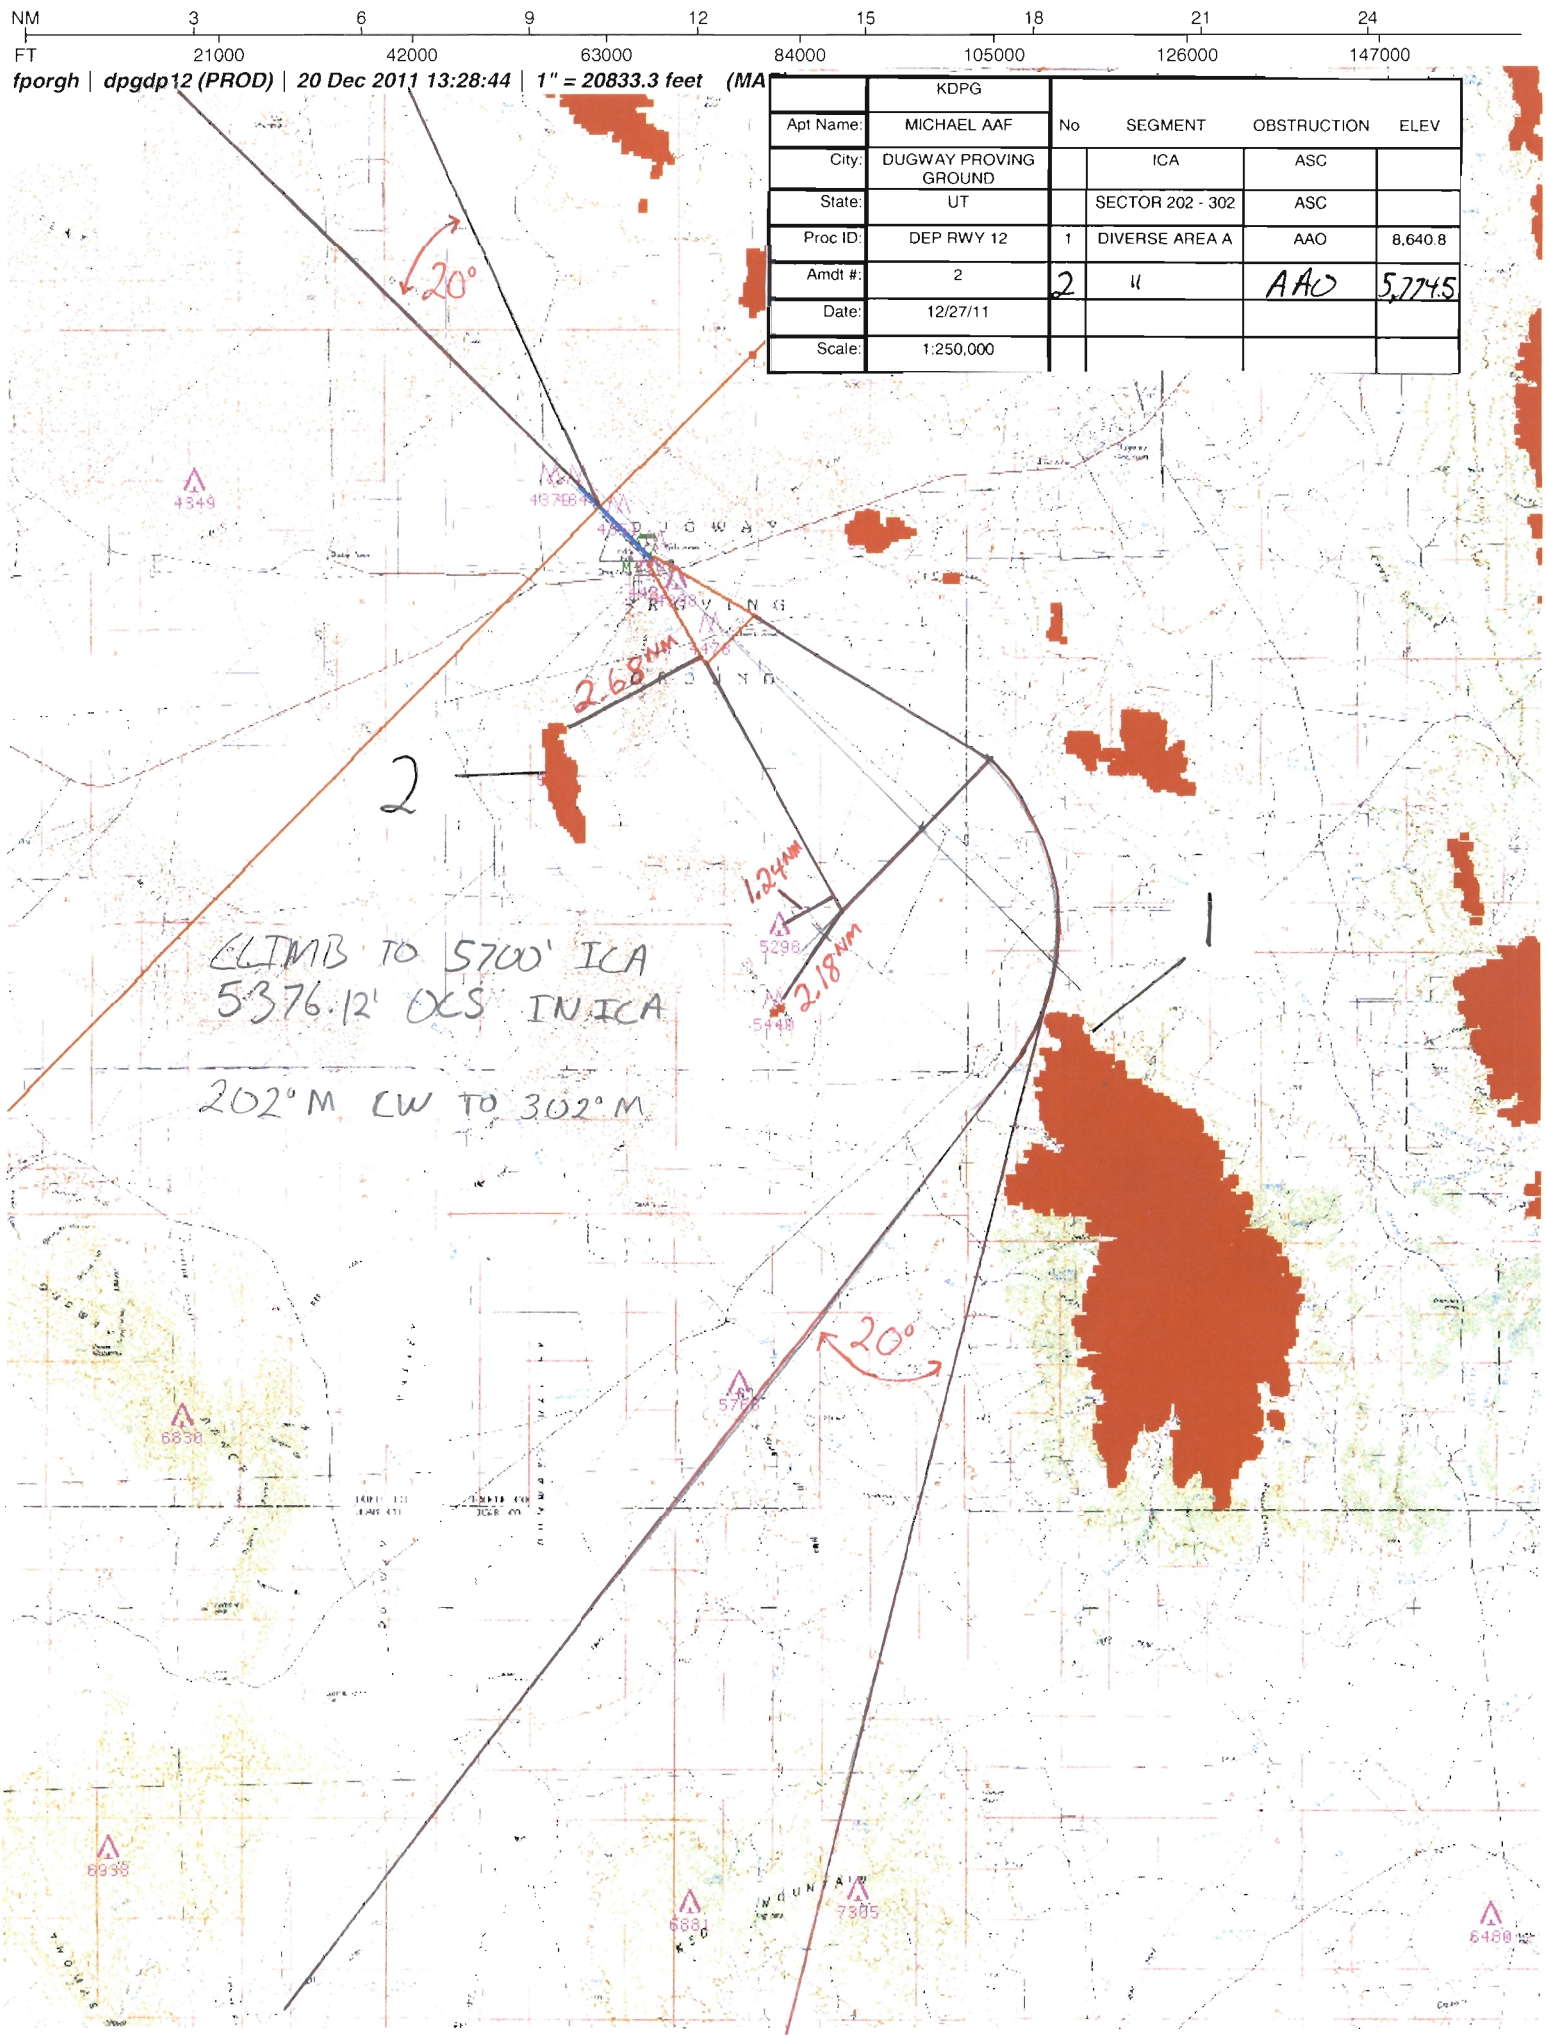
NM 3 6 9 12 15 18 21 24
FT 21000 42000 63000 84000 105000 126000 147000
fporgh | dpgdp12 (PROD) | 20 Dec 2011 13:28:44 | 1" = 20833.3 feet (MA
KDPG
Apt Name: MICHAEL AAF
City: DUGWAY PROVING GROUND
State: UT
Proc ID: DEP RWY 12
Amdt #: 2
Date: 12/27/11
Scale: 1:250,000
No SEGMENT OBSTRUCTION ELEV
ICA ASC
SECTOR 202 - 302 ASC
1 DIVERSE AREA A AAO 8,640.8
2 " AAO 5,774.5
20°
2.68NM
1.24NM
2.18NM
2
1
CLIMB TO 5700' ICA
5376.12' OCS IN ICA
202° M CW TO 302° M
20°

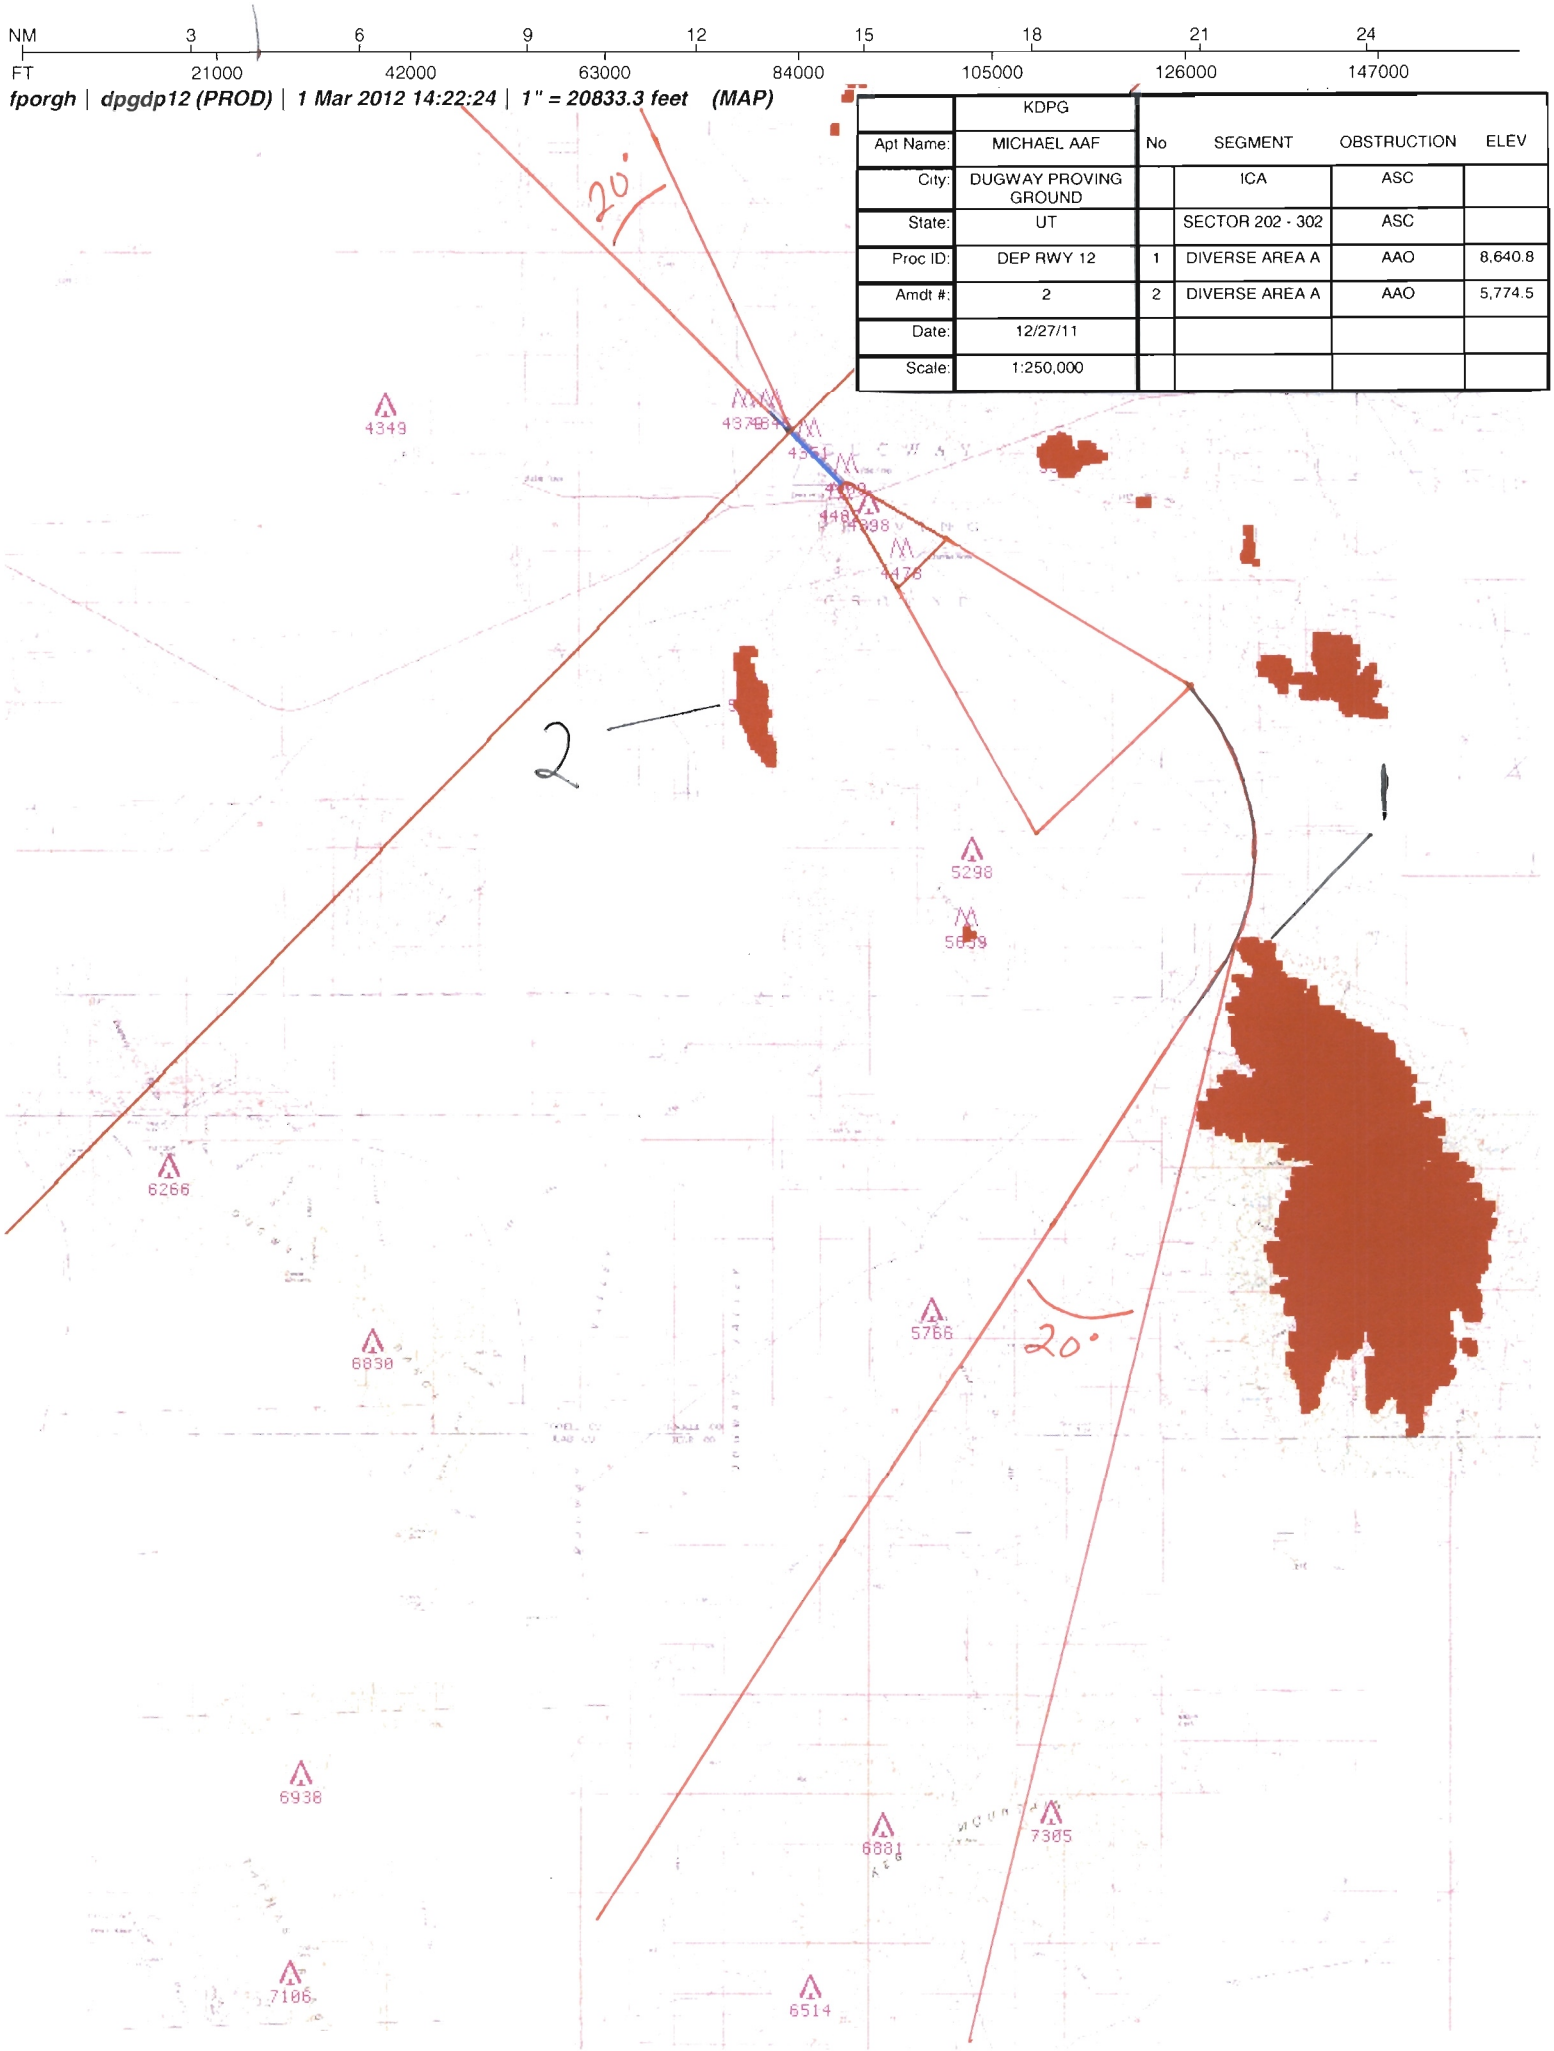
NM 3 6 9 12 15 18 21 24
FT 21000 42000 63000 84000 105000 126000 147000
fporgh | dpgdp12 (PROD) | 1 Mar 2012 14:22:24 | 1" = 20833.3 feet (MAP)
KDPG
Apt Name: MICHAEL AAF
City: DUGWAY PROVING GROUND
State: UT
Proc ID: DEP RWY 12
Amdt #: 2
Date: 12/27/11
Scale: 1:250,000
No SEGMENT OBSTRUCTION ELEV
ICA ASC
SECTOR 202 - 302 ASC
1 DIVERSE AREA A AAO 8,640.8
2 DIVERSE AREA A AAO 5,774.5
20°
20°
2
1
4349
4361
4398
4476
5298
5766
6266
6830
6938
6881
7305
7106
6514

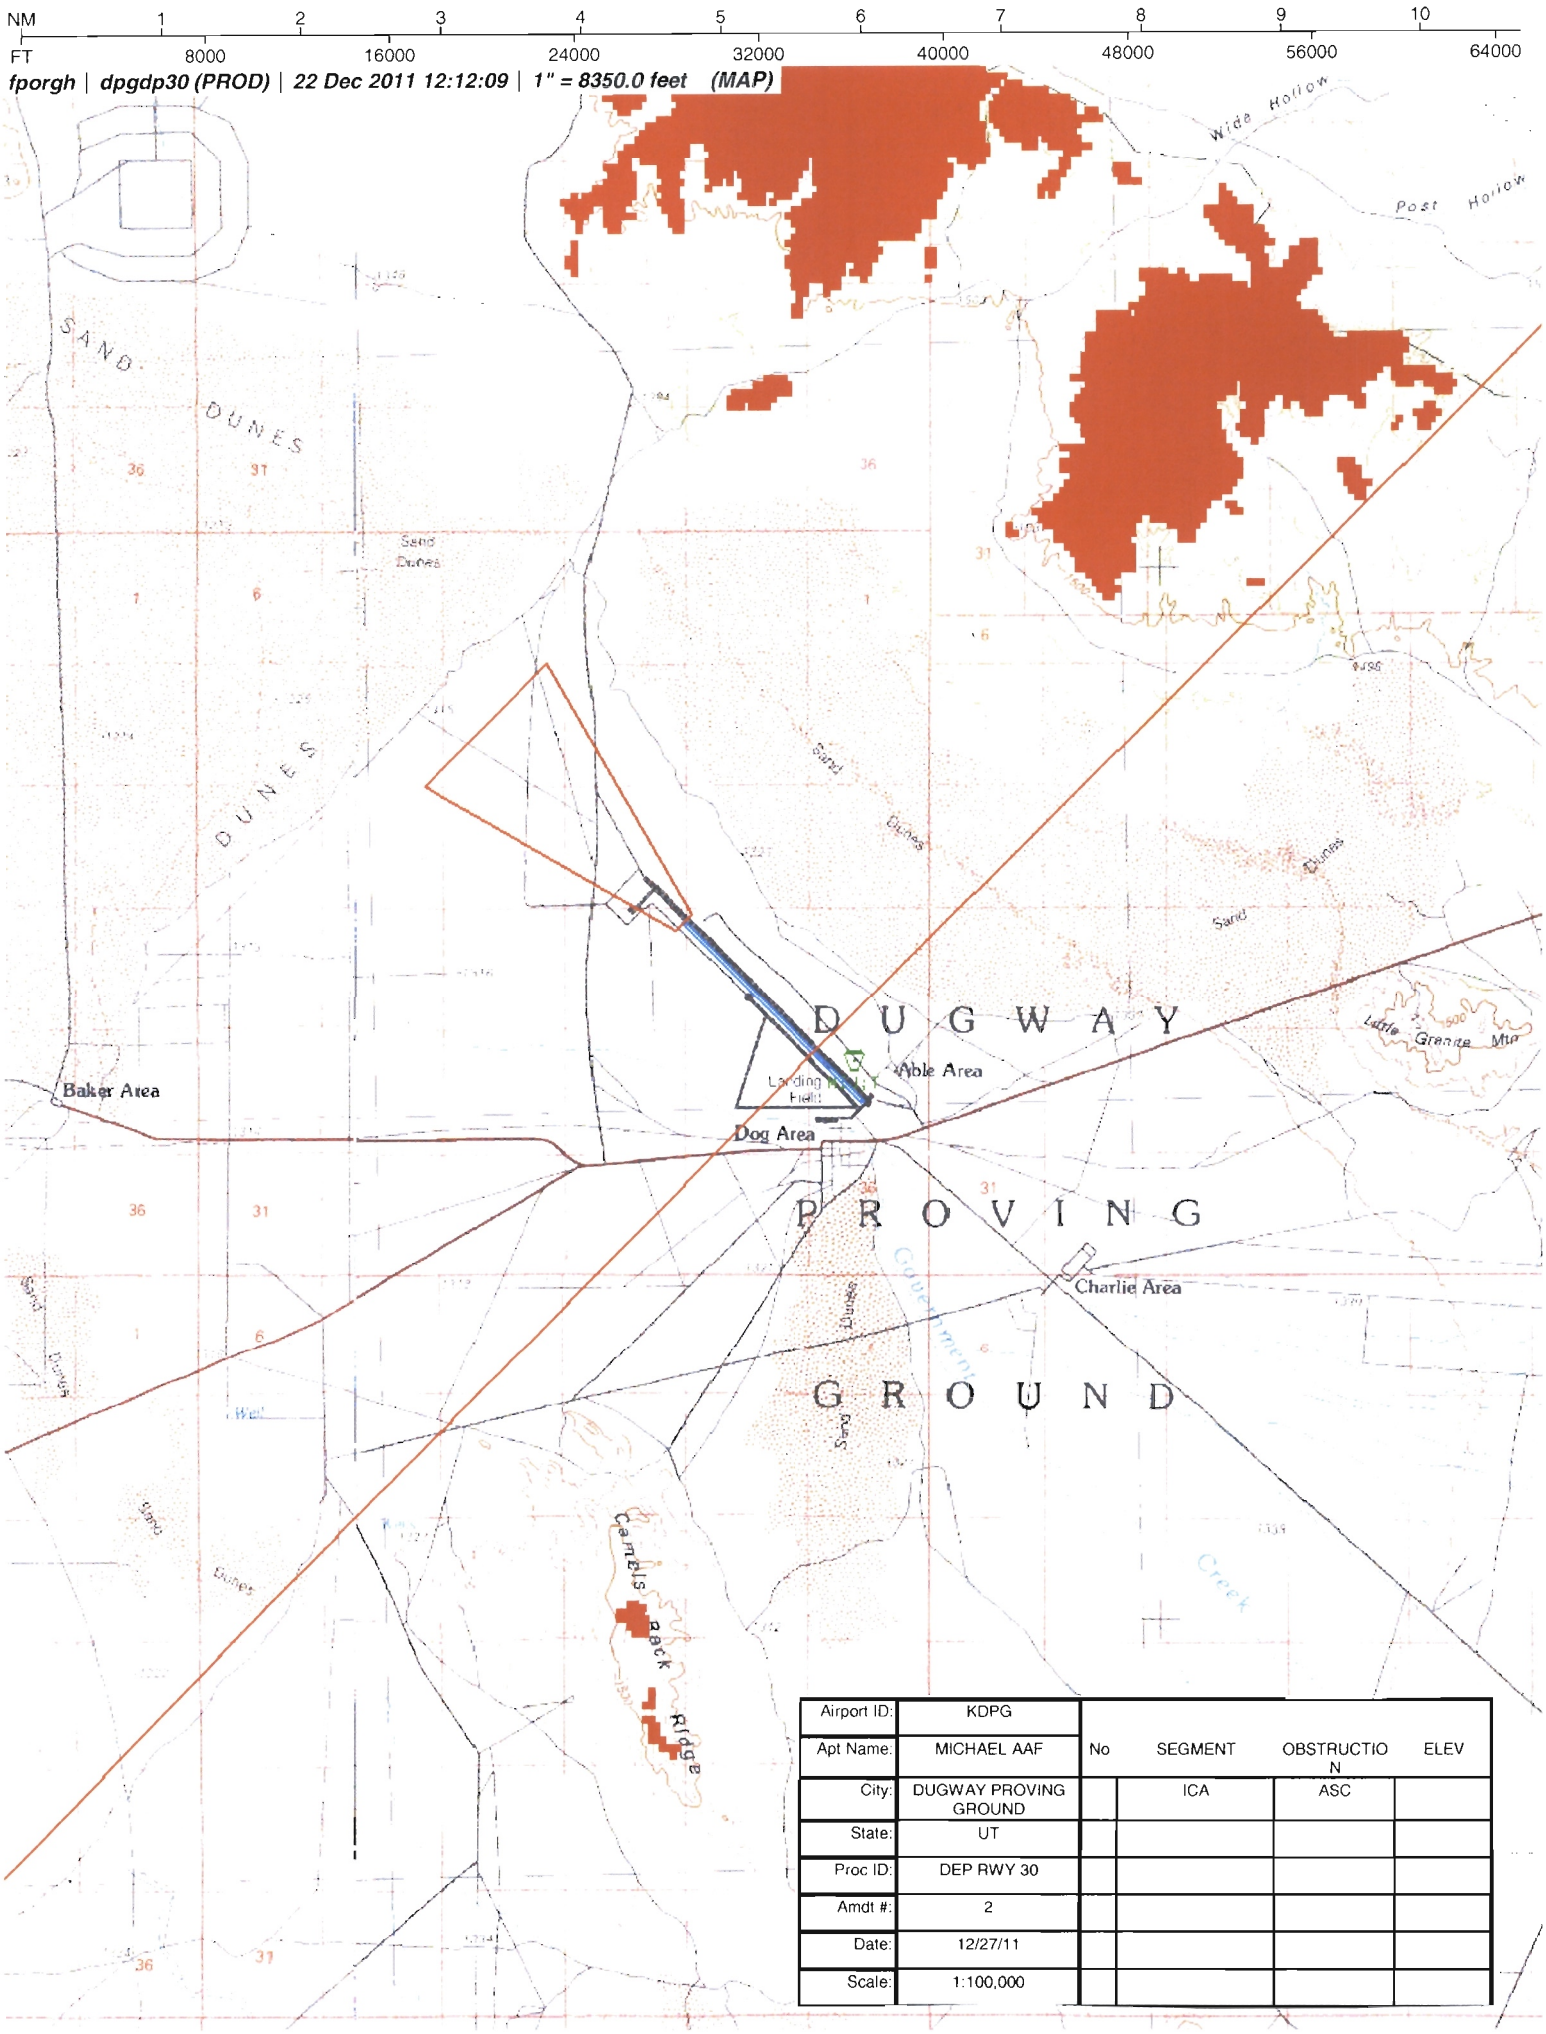

Airport ID:	KDPG				
Apt Name:	MICHAEL AAF	No	SEGMENT	OBSTRUCTION	ELEV
City:	DUGWAY PROVING GROUND		ICA	ASC	
State:	UT				
Proc ID:	DEP RWY 30				
Amdt #:	2				
Date:	12/27/11				
Scale:	1:100,000				

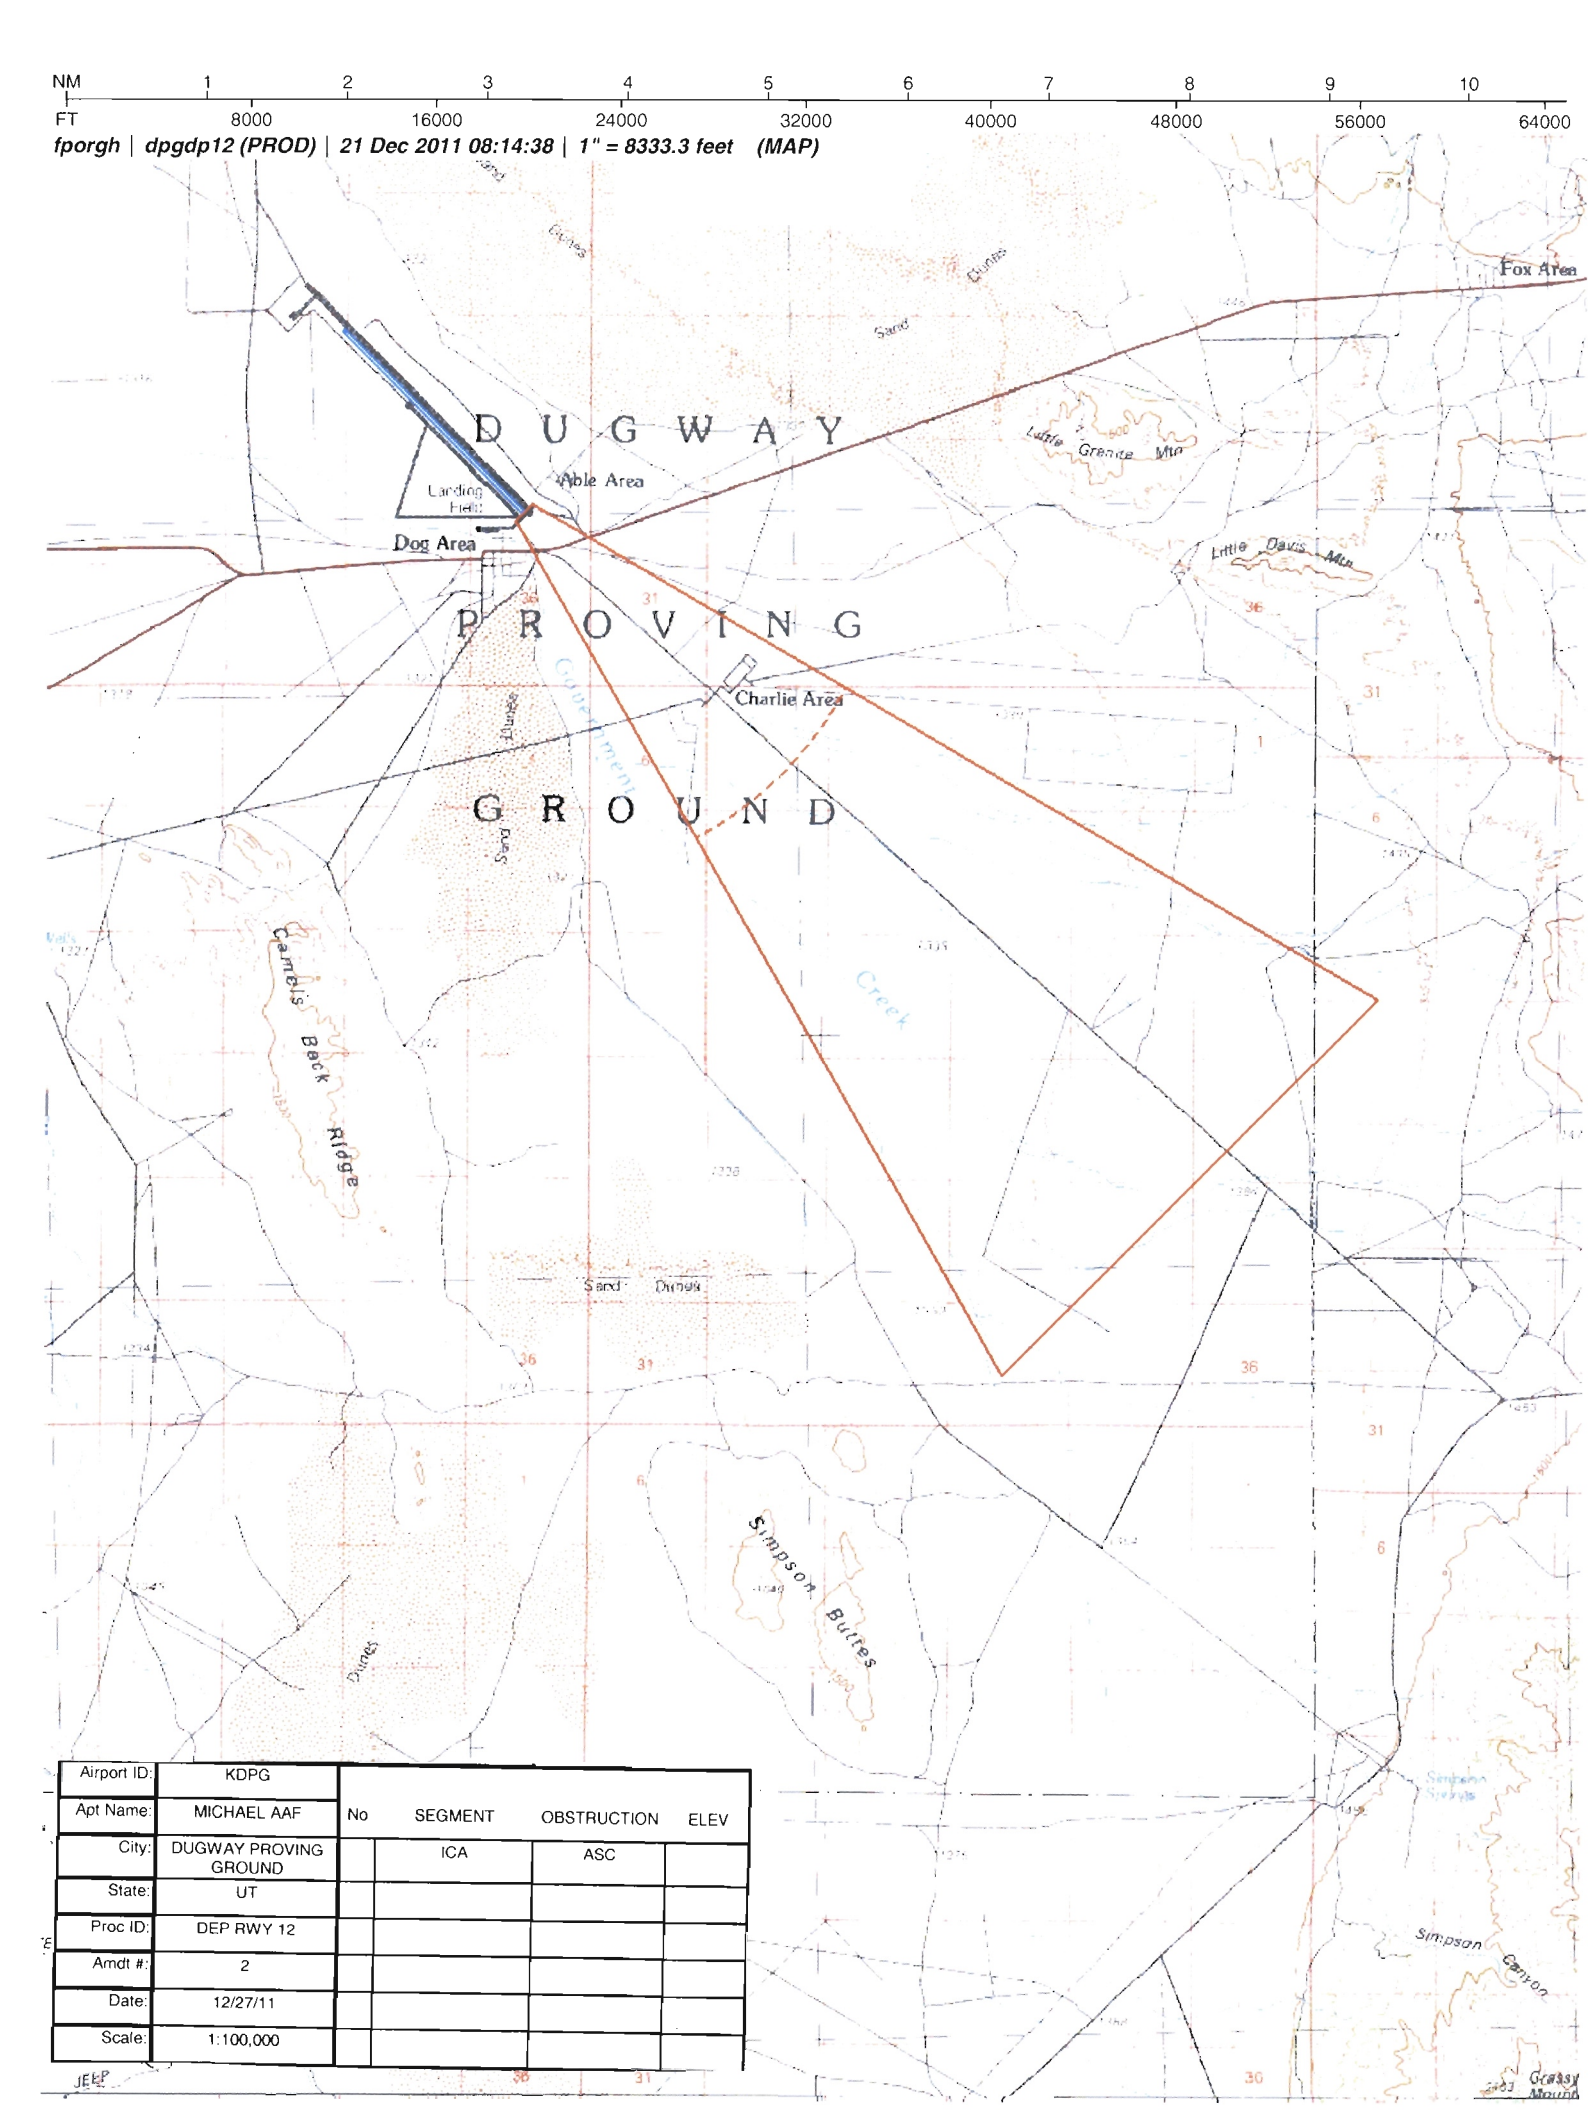

Airport ID:	KDPG
Apt Name:	MICHAEL AAF
City:	DUGWAY PROVING GROUND
State:	UT
Proc ID:	DEP RWY 12
Amdt #:	2
Date:	12/27/11
Scale:	1:100,000

No	SEGMENT	OBSTRUCTION	ELEV
	ICA	ASC	